



JEFFERSON COUNTY ENVIRONMENTAL HEALTH DEPARTMENT

COMPLETION CERTIFICATE FOR SUBSURFACE SEWAGE DISPOSAL SYSTEM

Issued to: Steve & Linda Eason
Owner/Developer/Contractor/Etc.

Location: Douglas Lake Est Lot 933-934

911 Address: _____

Type of System:


- () 1. Conventional
() 1a. Conventional w/Pump System
() 2. Low Pressure Pipe
() 3. Mound
(☒) 4. Chamber 21"
() 5. Large Diameter Graveless Pipe (10")
(a) Rock backfill required ☐ Yes ☐ No
() 5a. Large Diameter Graveless pipe (10") w/Pump System
(a) Rock backfill required ☐ Yes ☐ No
() 6. Other _____

System Specifications: (☒) New Installation () Repair () Other Installer: Russell Keet

() Lakeview 900 Septic Tank Estimated Absorption Rate: 45 Minutes Per Inch
Type Volume

Tank(s) and Field line approved: yes Pump & Alarm approved: NA System approved for: 1 w/ 100 ft. Yes () No (☒)
Bedrooms Footage Basement Plumbing

MAP NOT TO SCALE

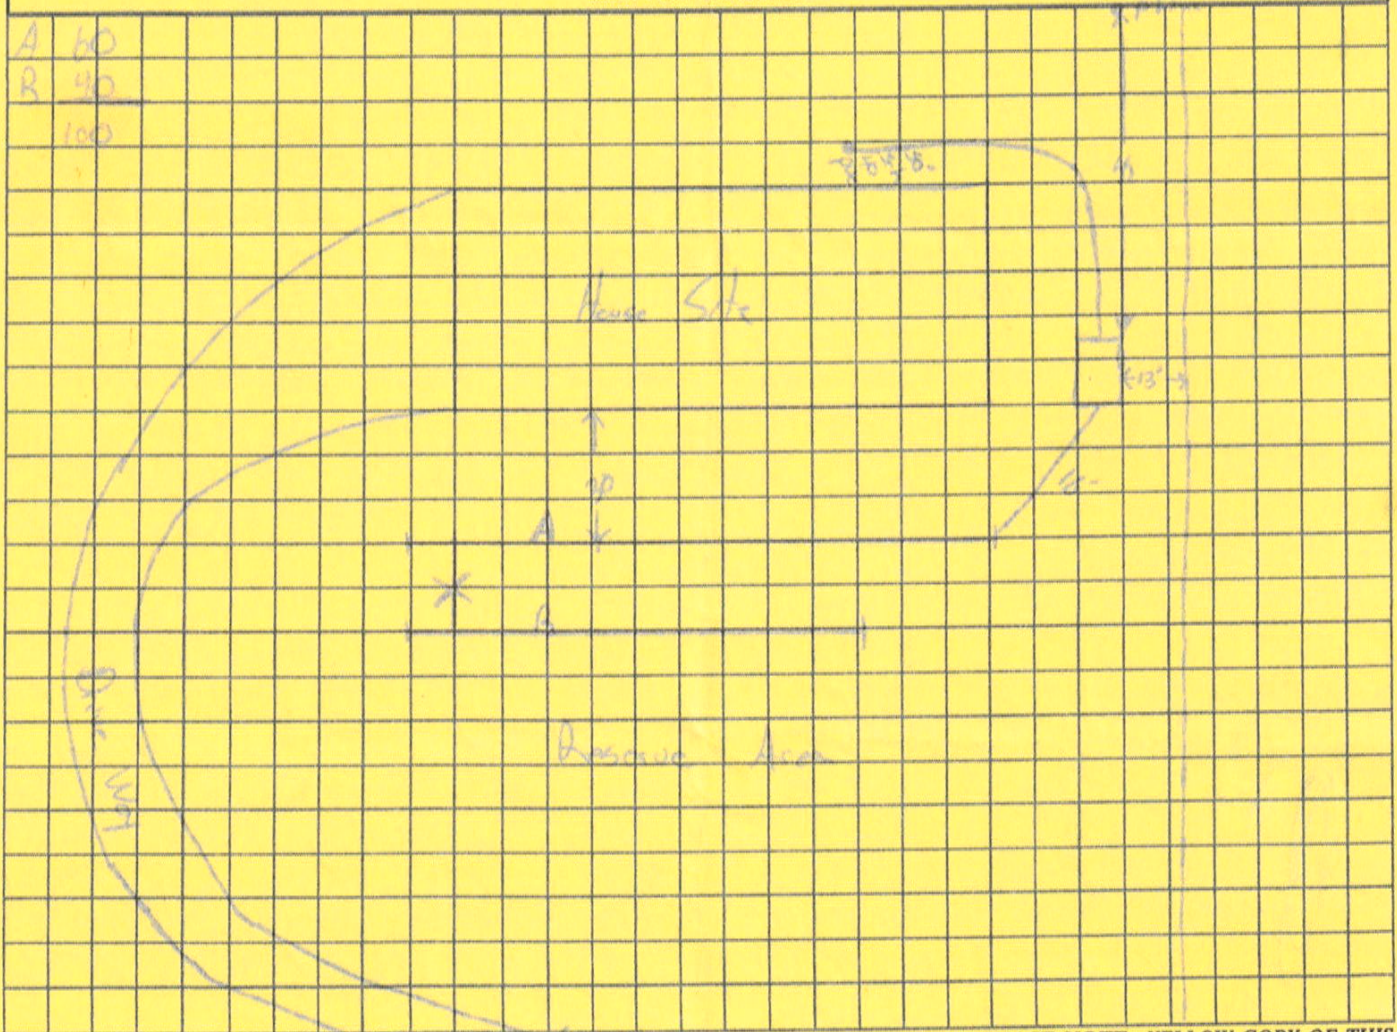

Construction Approved By: Eason Ball/EK 4-10-07
Name Title Date

PLEASE NOTE: YELLOW COPY OF THIS CERTIFICATE MAY BE NEEDED FOR FINAL ELECTRICAL INSPECTION. CONTACT YOUR LOCAL ELECTRIC COMPANY.