THIS FILE IS FOR THE MAIN HOUSE.
NO FILE WAS ON RECORD FOR THE HOUSE
AT THE TOP OF THE HILL.

KNOX COUNTY
TENNESSEE

Environmental Health Office
140 Dameron Avenue, Knoxville, TN 37917
Phone: 865-215-5200
www.knoxcounty.org/health/

Subsurface Sewage Disposal System File Search Application

To obtain records for a system in **Knox County only**, complete the information below.
Submit completed form to: **kchd.filesearch@knoxcounty.org**

Address and Parcel ID # listed below must match address as it is assigned by KGIS.

1. Current Owner's Name: Jerry H Wood Jr
2. Address: 602 Corum Road Zip Code: 37924
3. Parcel ID: (map and parcel) 073 149

Comments related to request: Need septic permit information, if any, on house at Corum, which has been combined with 536 Corum Road. Thank you!

****

For Environmental Health office documentation only: *Date received:* 9-14-26

RESULT OF FILE SEARCH

SSDS Certificate of Original System Completion was approved on _____ for a _____ bedroom system.

SSDS Certificate for Repair Completion was approved on 10-30-03 for a 2 bedroom system.

_____ No record of sewage system construction or approval was found in our files.

Comments: _____

Environmental Specialist: _____ Date: 9-15-26

Since no site visit has been made regarding this request, no comment or warranty about the current condition or future performance of the SSDS System is given. THIS IS NOT AN INSPECTION LETTER AND IS NOT TO BE USED FOR LOAN CLOSINGS OR BUILDING PERMITS. Nor can the Division make any representation about whether unauthorized modifications have been made to either the SSDS system or the original structure. This document only reflects what the Division's records show about the number of bedrooms authorized in the subsurface sewage system permit based on the information provided in this application.

KNOX COUNTY HEALTH DEPARTMENT – DIVISION OF ENVIRONMENTAL HEALTH
CERTIFICATE OF COMPLETION OF SUBSURFACE SEWAGE DISPOSAL SYSTEM


Issued to: Jeff Pratt
Owner, Developer, Contractor, Installer, Etc.

Location: 602 Colum Road

Notes:

Type of System:
( ) 1.Conventional
( ) 2 Alternating
( ) 3 Chapter _____
( ) 4.Low Pressure Pipe
( ) 5.Mound
( ) 6.Lagoon
( ) 7.Large Diameter Gravelless Pipe ( ) 8" ( ) 10"
(✓) 8.Chamber ( ) 2' (✓) 3'
( ) 9.Other _____

200 _____ Septic Tank
(Drainfield Size) (Volume)
Estimated Absorption Rate _____
Bedrooms _____
( ) New installation (✓) Repair ( ) Other
Installed by: Scott/ Mantooth

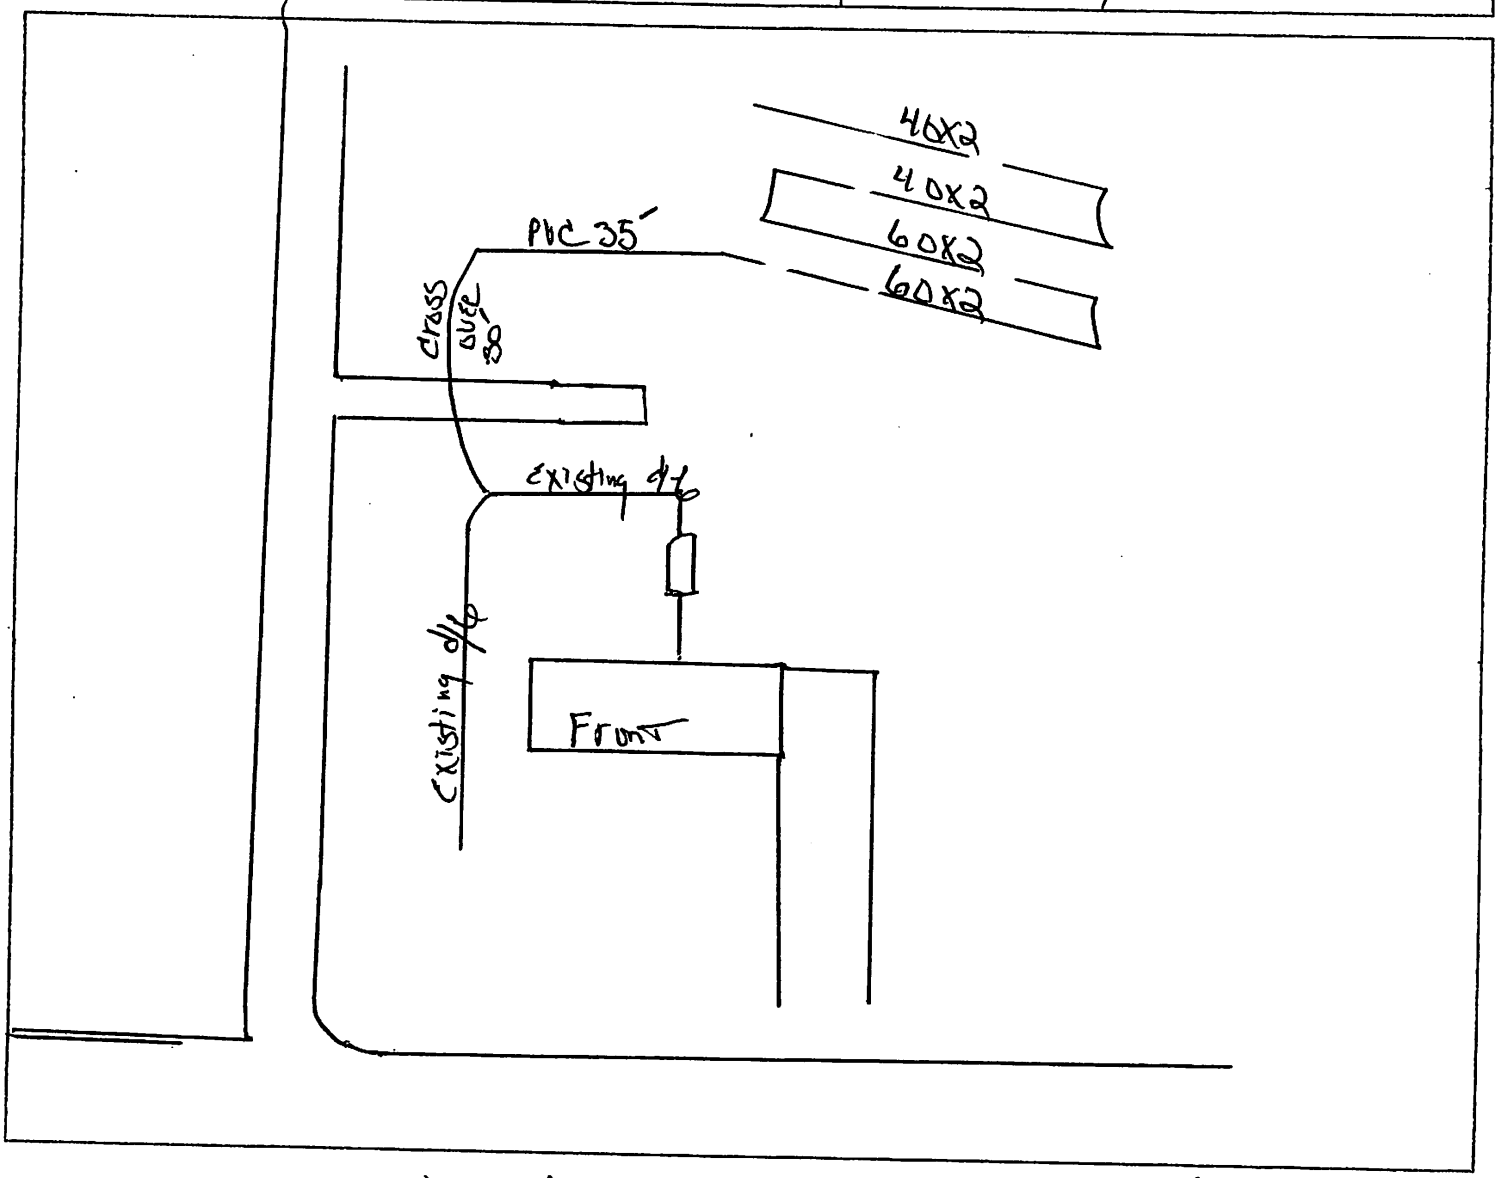

Construction Approved By: John Villotte 10/30/03
(Name and Title) (date)

KCHD 2344 (Rev. 12-30-02)